EXTERIOR FINISH SCHEDULE

ITEM	EXTERIOR FINISH	MANUFACTURER	COLOR	COMMENTS
ACM-1	ALUMINUM COMPOSITE METAL PANEL	ALCOA ARCHITECTURAL REYNOBOND	CUSTOM FIFTH THIRD BLUE	4MM FR CORE ALUM. COMPOSITE PANEL, DURAGLOSS 3000
ACM-2	ALUMINUM COMPOSITE METAL PANEL	ALCOA ARCHITECTURAL REYNOBOND	CUSTOM FIFTH THIRD GREEN	4MM FR CORE ALUM. COMPOSITE PANEL, DURAGLOSS 3000
ACM-3	ALUMINUM COMPOSITE METAL PANEL	ALCOA ARCHITECTURAL REYNOBOND	ANODIC CLEAR	4MM FR CORE ALUM. COMPOSITE PANEL, COLORWELD 500
AL-1	ANODIZED ALUMINUM	YKK	CLEAR ANODIZED	BASIS OF DESIGN: 2" X 4 1/2" YKK YES45 TU CENTER SET STOREFRONT
EIFS-1	EIFS BARRIER SYSTEM	DRYVIT OUTSULATION PLUS MD	DOVER SKY	3" EIFS SYSTEM - TYP., SANDBLAST FINISH
EIFS-2	EIFS BARRIER SYSTEM	DRYVIT OUTSULATION PLUS MD	DOVER SKY	5" EIFS SYSTEM @ VESTIBULE PARAPET, SANDBLAST FINISH
EPT-1	PAINTED GALVANIZED STEEL GATE	BENJAMIN MOORE	BALBOA MIST - OC27	SEMI-GLOSS @ STEEL, SATIN FINISH @ WALLS
EXT-1	STANDARD MODULAR BRICK VENEER	ACME BRICK	SLATE GRAY	MORTAR MANUFACTURER: COOSA , MORTAR COLOR: OLD LIME PUTTY
GL-1	EXTERIOR GLAZING	VITRO	SOLARBAN 90 ACUITY + ACUITY	ARGON U-0.24, SHCC=0.23
M-1	PREFINISHED METAL COPING	PAC-CLAD	MATCH ACM-3	

GLAZING - GENERAL NOTES

EXTERIOR GLAZING BASIS OF DESIGN:

REGULAR EXTERIOR STOREFRONT:
YKK YES45 TU - CENTER SET THERMALLY BROKEN STOREFRONT, 1" PANEL INFILL
2" X 4 1/2" MULLION

EXTERIOR INSULATED GLASS UNIT:
VITRO SOLARBAN 90 (2) ACUITY + ACUITY
OVERALL THICKNESS: 1 INCH
VLT: 53%
EXT. REFLECTANCE: 12%
INT. REFLECTANCE: 19%
U-VALUE (ARGON): 0.24
SHGC: 0.23
LSG: 2.30
PROVIDE SAFETY GLAZING LABELING

INTERIOR GLAZING BASIS OF DESIGN:
YKK YES45 FS - CENTER SET, 1/4" PANEL INFILL
1 3/4" X 4 1/2" MULLION

INTERIOR GLASS UNIT:
CLEAR FLOAT GLASS, FULLY TEMPERED
OVERALL THICKNESS: 6mm (1/4")
PROVIDE SAFETY GLAZING LABELING

ACM PANEL - GENERAL NOTES

A. ALL ACM PANELS MUST BE ANCHORED TO MINIMUM 16 GA METAL STUD FRAMING. REFER TO STRUCTURAL. METAL STUD FRAMING NOT BY CA SYSTEMS.

B. METAL STUDS MUST ALIGN WITH PANEL JOINTS AS REQUIRED FOR METAL COMPOSITE PANEL ATTACHMENT.

C. FIXED STUDS MAY BE USED TO SUPPORT METAL COMPOSITE PANELS (G.C. TO COORDINATE)

D. 5/8" GYP. BD SHEATHING AND/OR GLASS MAT SHEATHING WILL NOT SUPPORT METAL COMPOSITE PANEL ATTACHMENT (SHEATHING NOT BY CA SYSTEMS)

E. ALL FLATSTOCK FABRICATED FLASHING REQUIRED FOR METAL COMPOSITE PANEL DETAILS TO BE PREFINISHED ALUMINUM. COLOR TO MATCH U.N.O.

F. ALL DIMENSIONS AND QUANTITIES ARE TO BE FIELD VERIFIED PRIOR TO THE FABRICATION (RELEASE) OF ANY & ALL METAL COMPOSITE PANEL AND ASSOCIATED FLASHINGS.

G. ALL SKYWARD ACM PANEL JOINTS TO HAVE BACKER ROD AND CAULK. APPLY DOWN PAST WOOD BLOCKING, TYP.

H. USE BACKER ROD AND CAULK AT ALL VERTICAL PANEL END (JAMB) CONDITIONS AT DISSIMILAR MATERIALS (IE, STUCCO, WINDOW MULLIONS)

I. ALL SKYWARD ACM PANEL JOINTS TO HAVE BACKER ROD AND CAULK. APPLY DOWN PAST WOOD BLOCKING, TYP. USE BACKER ROD AND CAULK AT ALL VERTICAL PANEL END (JAMB) JOINT CONDITIONS AT DISSIMILAR MATERIALS (IE STUCCO, WINDOW MULLION)

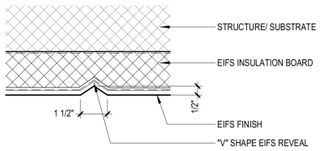

EIFS REVEAL | 3" = 1'-0" | R1

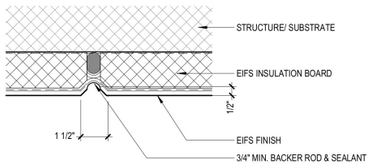

EIFS CONTROL JOINT | 3" = 1'-0" | CJ

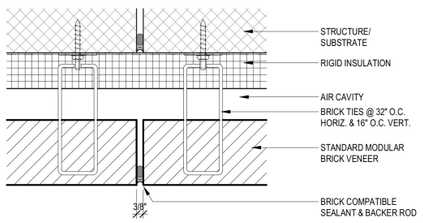

BRICK CONTROL JOINT | 3" = 1'-0" | CJ

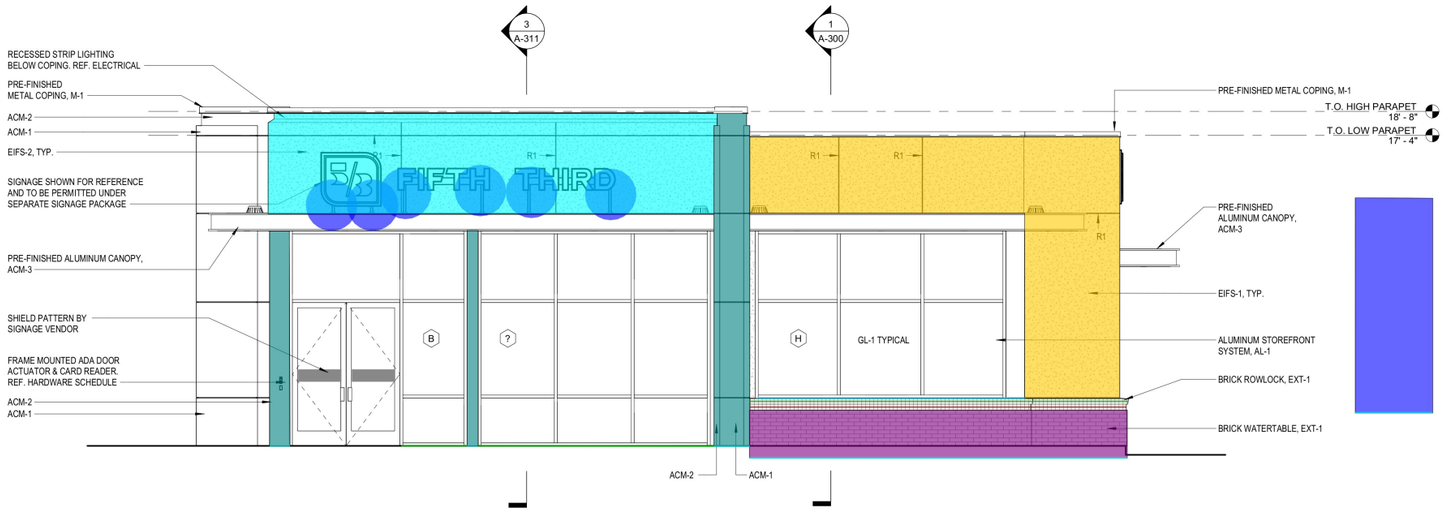

WEST ELEVATION | 1/4" = 1'-0" | 2

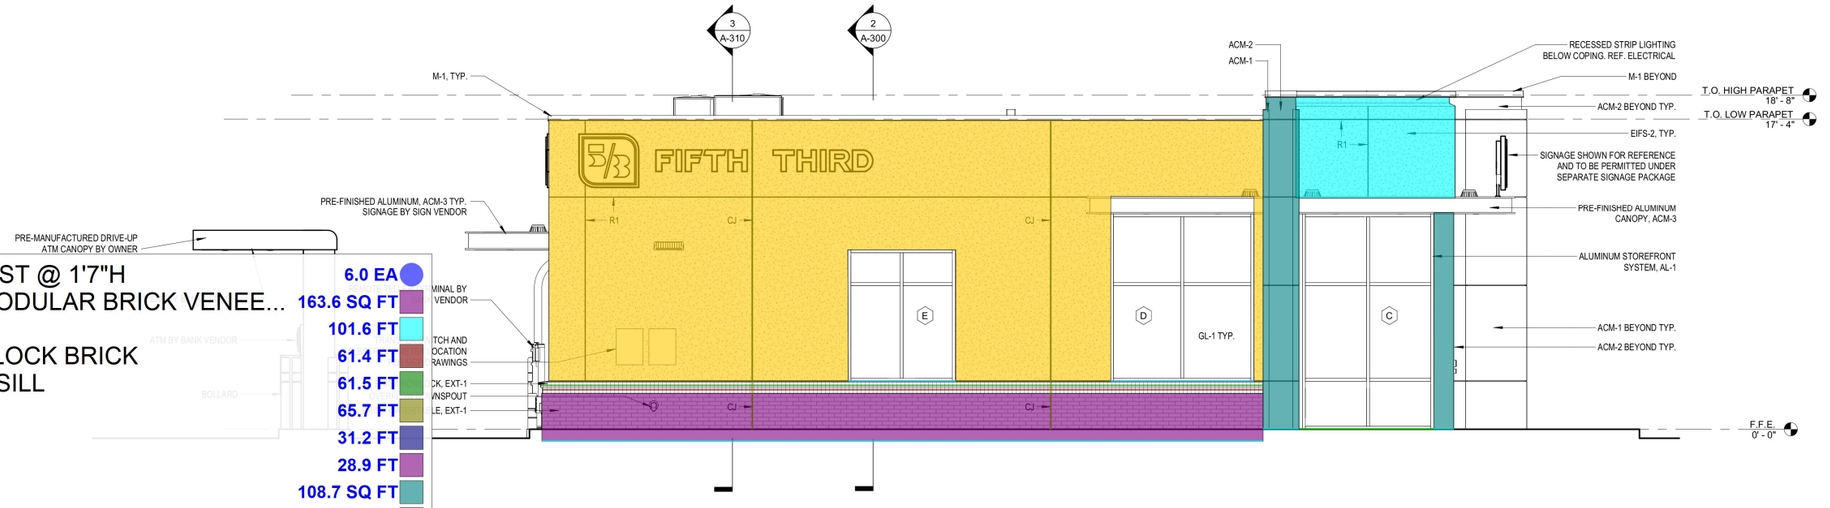

NORTH ELEVATION | 1/4" = 1'-0" | 1

HSS1-1/2"x1-1/2"x3/16" TUBE POST @ 1'7"H	6.0 EA
EXT-1: 3-5/8"THK. STANDARD MODULAR BRICK VENEE...	163.6 SQ FT
THRU WALL FLASHING	101.6 FT
3-1/4"THK. x 3-5/8"H HALF ROWLOCK BRICK	61.4 FT
7-5/8"THK. x 3-5/8"H ROWLOCK SILL	61.5 FT
SEALANT W/ BACKER ROD	65.7 FT
ALUMINUM FLASHING	31.2 FT
PRE-FINISHED ALUMINUM SILL	28.9 FT
ACM1, ACM2 FINISH - 1/A440	108.7 SQ FT
5/8" PLYWOOD SHEATHING	52.1 SQ FT
EIFS-1	599.9 SQ FT
EIFS-2	189.7 SQ FT
Linear	24.4 FT

PRAXIS3

100 Peachtree St NW
Suite 1450
Atlanta, GA 30303
404-875-4500 tel
www.praxis3.com

STATE OF GEORGIA
STUART M. ROMM
07/02/26
CERTIFICATE NO. 34651
REGISTERED ARCHITECT

Copyright (c) 2026 Praxis3, LLC

All reports, plans, specifications, computer files, field data, notes and other documents and instruments prepared by Praxis3 shall retain all common law, statutory and other reserved rights, including copyright thereto.

This drawing may not be reproduced in whole or in part without written permission of Praxis3. It is to be returned upon request. Scales as stated are valid on the original drawings.

Rev	Date	Comments
	07/02/2026	PERMIT SET

Client:
FIFTH THIRD BANK

Project Number: 26302
Project Name:
WATSON BLVD.

2711 WATSON BOULEVARD
WARNER ROBINS, GA 31093

Key Plan:

Sheet Title:
EXTERIOR ELEVATIONS

Sheet Number:
A-200

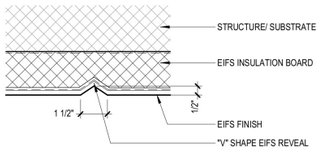

EIFS REVEAL | 3" = 1'-0" | R1

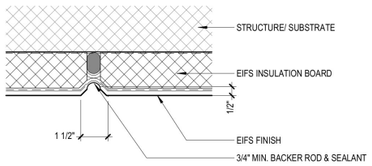

EIFS CONTROL JOINT | 3" = 1'-0" | CJ

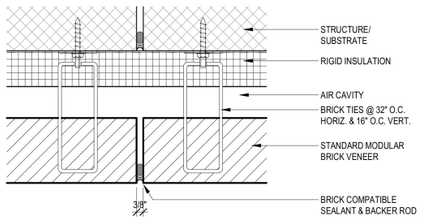

BRICK CONTROL JOINT | 3" = 1'-0" | CJ

EXTERIOR FINISH SCHEDULE

ITEM	EXTERIOR FINISH	MANUFACTURER	COLOR	COMMENTS
ACM-1	ALUMINUM COMPOSITE METAL PANEL	ALCOA ARCHITECTURAL REYNOBOND	CUSTOM FIFTH THIRD BLUE	4MM FR CORE ALUM. COMPOSITE PANEL, DURAGLOSS 3000
ACM-2	ALUMINUM COMPOSITE METAL PANEL	ALCOA ARCHITECTURAL REYNOBOND	CUSTOM FIFTH THIRD GREEN	4MM FR CORE ALUM. COMPOSITE PANEL, DURAGLOSS 3000
ACM-3	ALUMINUM COMPOSITE METAL PANEL	ALCOA ARCHITECTURAL REYNOBOND	ANODIC CLEAR	4MM FR CORE ALUM. COMPOSITE PANEL, COLORWELD 500
AL-1	ANODIZED ALUMINUM	YKK	CLEAR ANODIZED	BASIS OF DESIGN: 2" X 4 1/2" YKK YES45 TU CENTER SET STOREFRONT
EIFS-1	EIFS BARRIER SYSTEM	DRYVIT OUTSULATION PLUS MD	DOVER SKY	3" EIFS SYSTEM - TYP., SANDBLAST FINISH
EIFS-2	EIFS BARRIER SYSTEM	DRYVIT OUTSULATION PLUS MD	DOVER SKY	5" EIFS SYSTEM @ VESTIBULE PARAPET, SANDBLAST FINISH
EPT-1	PAINTED GALVANIZED STEEL GATE	BENJAMIN MOORE	BALBOA MIST - OC27	SEMI-GLOSS @ STEEL, SATIN FINISH @ WALLS
EXT-1	STANDARD MODULAR BRICK VENEER	ACME BRICK	SLATE GRAY	MORTAR MANUFACTURER: COOSA , MORTAR COLOR: OLD LIME PUTTY
GL-1	EXTERIOR GLAZING	VITRO	SOLARBAN 90 ACUITY + ACUITY	ARGON U-0.24, SHCC=0.23
M-1	PREFINISHED METAL COPING	PAC-CLAD	MATCH ACM-3	

GLAZING - GENERAL NOTES

EXTERIOR GLAZING BASIS OF DESIGN:

REGULAR EXTERIOR STOREFRONT:
YKK YES45 TU - CENTER SET THERMALLY BROKEN STOREFRONT, 1" PANEL INFILL
2" X 4 1/2" MULLION

EXTERIOR INSULATED GLASS UNIT:
VITRO SOLARBAN 90 (2) ACUITY + ACUITY
OVERALL THICKNESS: 1 INCH
VLT: 53%
EXT. REFLECTANCE: 12%
INT. REFLECTANCE: 19%
U-VALUE (ARGON): 0.24
SHGC: 0.23
LSG: 2.30
PROVIDE SAFETY GLAZING LABELING

INTERIOR GLAZING BASIS OF DESIGN:
YKK YES45 FS - CENTER SET, 1/4" PANEL INFILL
1 3/4" X 4 1/2" MULLION

INTERIOR GLASS UNIT:
CLEAR FLOAT GLASS, FULLY TEMPERED
OVERALL THICKNESS: 6mm (1/4")
PROVIDE SAFETY GLAZING LABELING

ACM PANEL - GENERAL NOTES

A. ALL ACM PANELS MUST BE ANCHORED TO MINIMUM 16 GA METAL STUD FRAMING. REFER TO STRUCTURAL. METAL STUD FRAMING NOT BY CA SYSTEMS.

B. METAL STUDS MUST ALIGN WITH PANEL JOINTS AS REQUIRED FOR METAL COMPOSITE PANEL ATTACHMENT.

C. FIXED STUDS MAY BE USED TO SUPPORT METAL COMPOSITE PANELS (G.C. TO COORDINATE)

D. 5/8" GYP. BD SHEATHING AND/OR GLASS MAT SHEATHING WILL NOT SUPPORT METAL COMPOSITE PANEL ATTACHMENT (SHEATHING NOT BY CA SYSTEMS)

E. ALL FLATSTOCK FABRICATED FLASHING REQUIRED FOR METAL COMPOSITE PANEL DETAILS TO BE PREFINISHED ALUMINUM. COLOR TO MATCH U.N.O.

F. ALL DIMENSIONS AND QUANTITIES ARE TO BE FIELD VERIFIED PRIOR TO THE FABRICATION (RELEASE) OF ANY & ALL METAL COMPOSITE PANEL AND ASSOCIATED FLASHINGS.

G. ALL SKYWARD ACM PANEL JOINTS TO HAVE BACKER ROD AND CAULK. APPLY DOWN PAST WOOD BLOCKING, TYP.

H. USE BACKER ROD AND CAULK AT ALL VERTICAL PANEL END (JAMB) CONDITIONS AT DISSIMILAR MATERIALS (IE, STUCCO, WINDOW MULLIONS)

I. ALL SKYWARD ACM PANEL JOINTS TO HAVE BACKER ROD AND CAULK. APPLY DOWN PAST WOOD BLOCKING, TYP. USE BACKER ROD AND CAULK AT ALL VERTICAL PANEL END (JAMB) JOINT CONDITIONS AT DISSIMILAR MATERIALS (IE STUCCO, WINDOW MULLION)

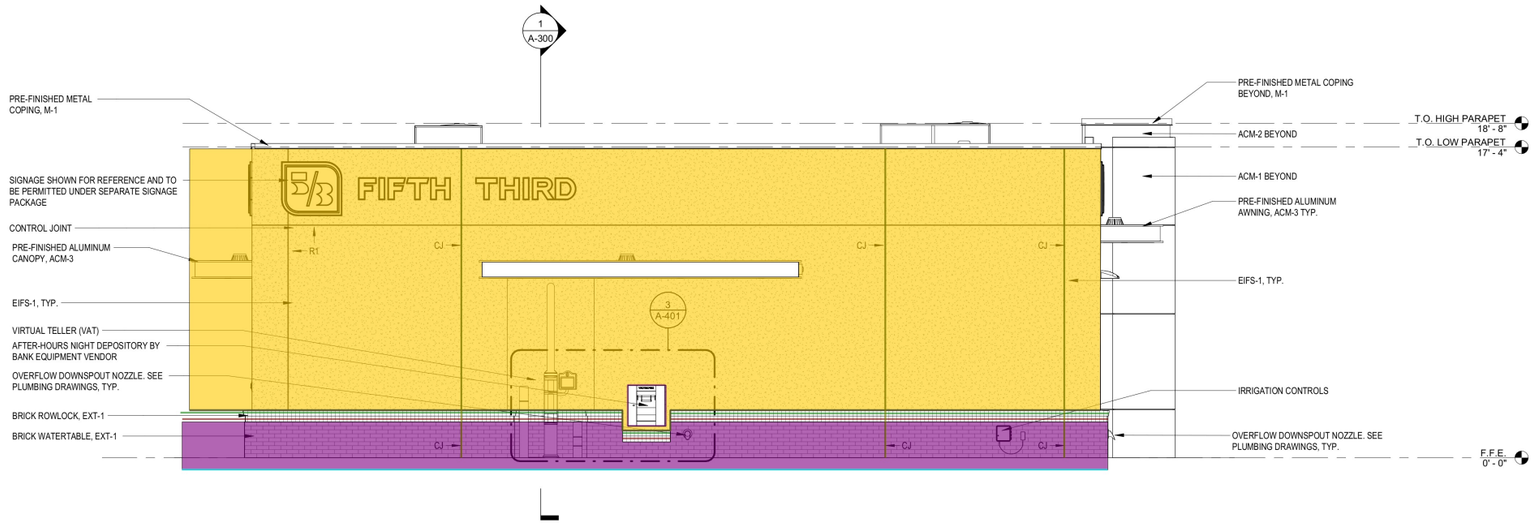

EAST ELEVATION | 1/4" = 1'-0" | 2

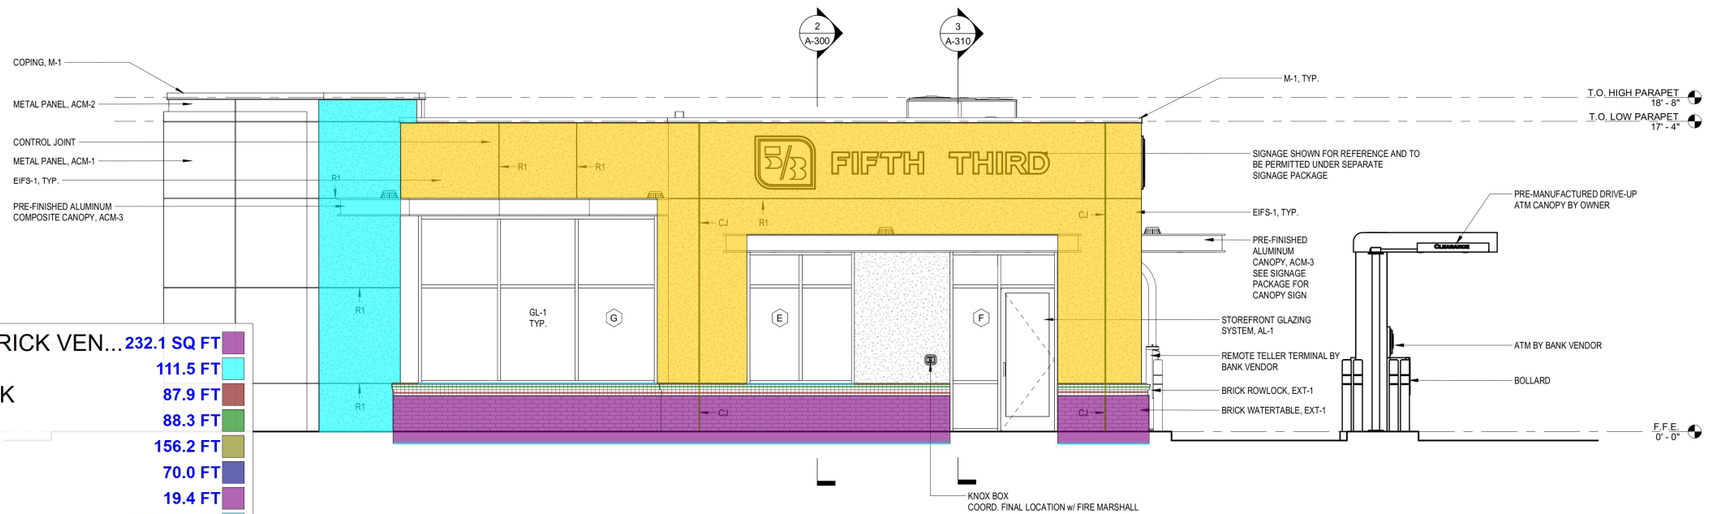

SOUTH ELEVATION | 1/4" = 1'-0" | 1

EXT-1: 3-5/8"THK. STANDARD MODULAR BRICK VEN...	232.1 SQ FT
THRU WALL FLASHING	111.5 FT
3-1/4"THK. x 3-5/8"H HALF ROWLOCK BRICK	87.9 FT
7-5/8"THK. x 3-5/8"H ROWLOCK SILL	88.3 FT
SEALANT W/ BACKER ROD	156.2 FT
ALUMINUM FLASHING	70.0 FT
PRE-FINISHED ALUMINUM SILL	19.4 FT
EIFS-2	84.7 SQ FT
EIFS-1	1039.0 SQ FT
2x6 BLOCKING	8.8 FT

PRAXIS3
100 Peachtree St NW
Suite 1450
Atlanta, GA 30303
404-875-4500 tel
www.praxis3.com

STATE OF GEORGIA
STUART M. ROMM
07/02/26
CERTIFICATE NO. 34651
REGISTERED ARCHITECT

Copyright (c) 2026 Praxis3, LLC

All reports, plans, specifications, computer files, field data, notes and other documents and instruments prepared by Praxis3 shall retain all common law, statutory and other reserved rights, including copyright thereto.

This drawing may not be reproduced in whole or in part without written permission of Praxis3. It is to be returned upon request. Scales as stated are valid on the original drawings.

Rev	Date	Comments
	07/02/2026	PERMIT SET

Client:
FIFTH THIRD BANK

Project Number: 26302
Project Name:
WATSON BLVD.

2711 WATSON BOULEVARD
WARNER ROBINS, GA 31093

Key Plan:

Sheet Title:
EXTERIOR ELEVATIONS

Sheet Number:
A-201

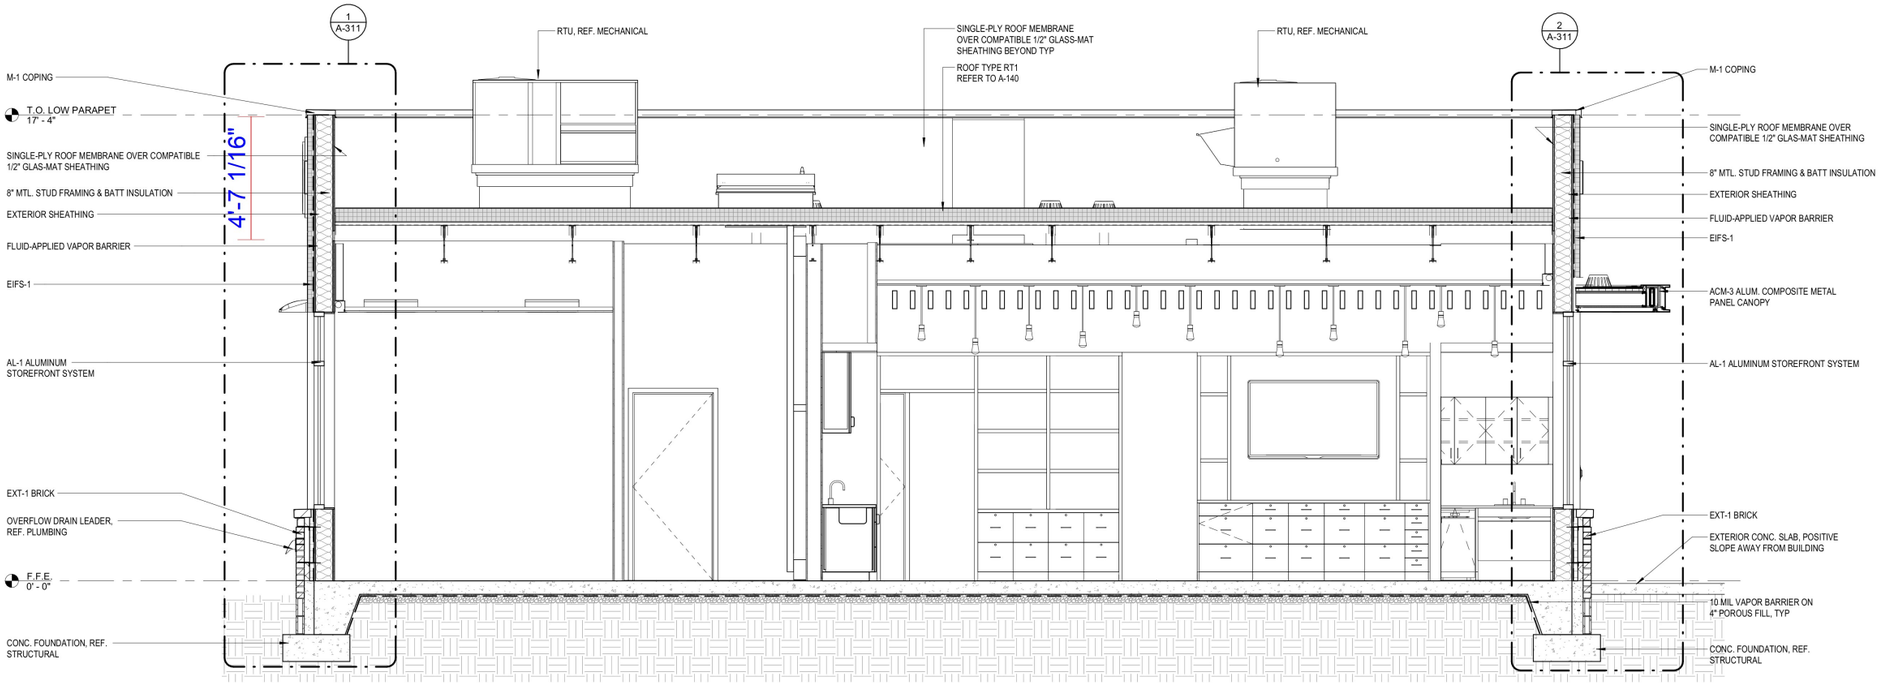

BUILDING SECTION | 3/8" = 1'-0" | 2

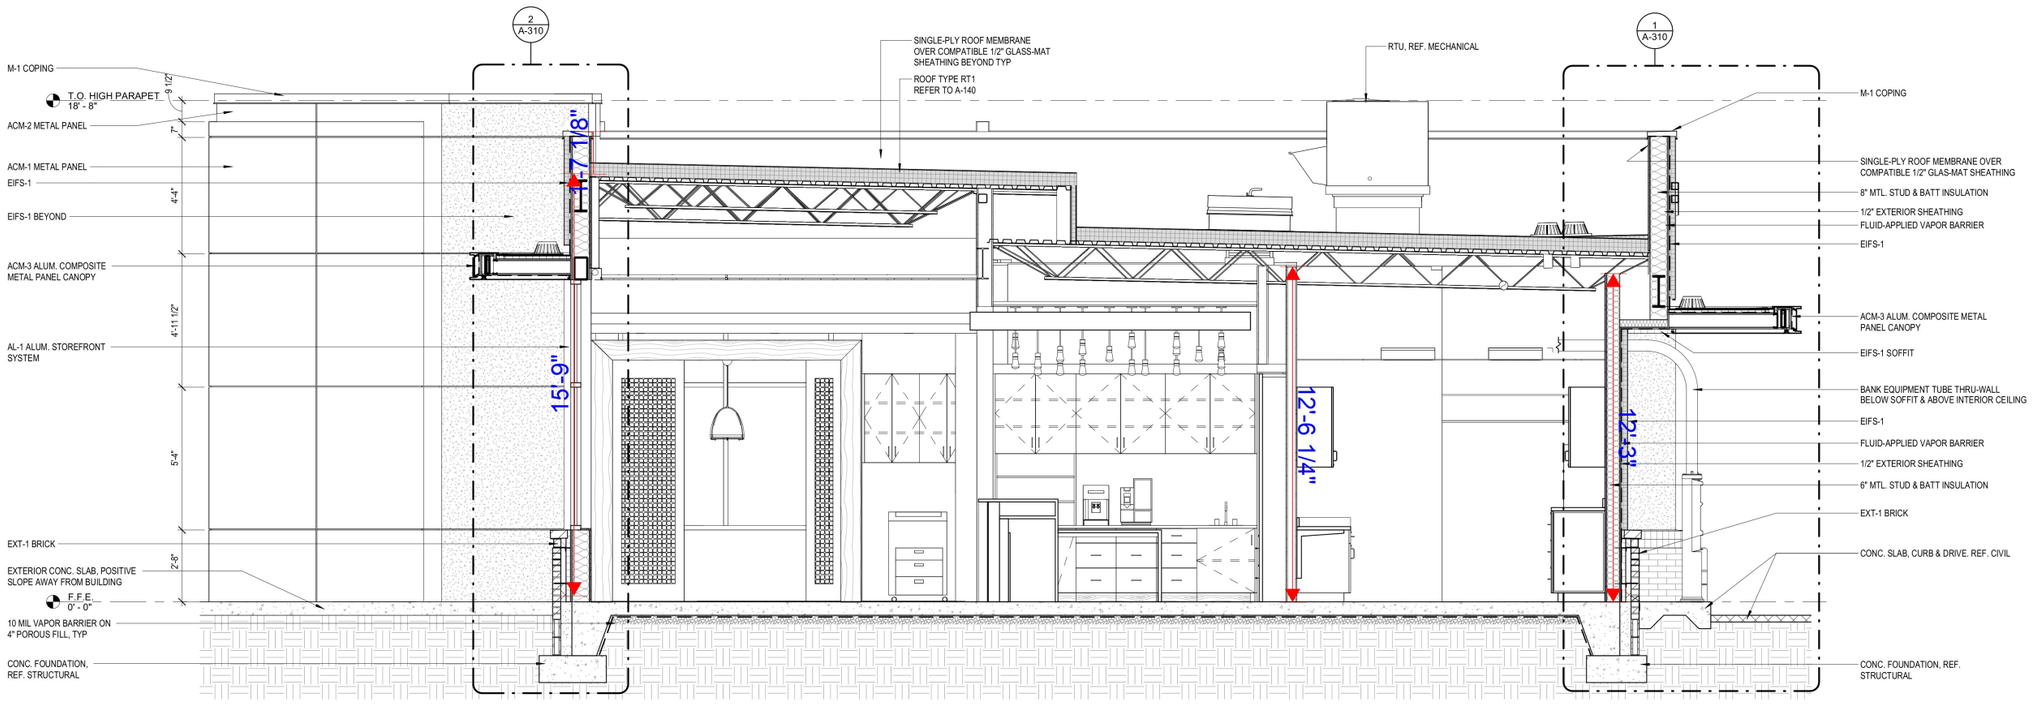

BUILDING SECTION | 3/8" = 1'-0" | 1

7/8/2026 2:38:27 PM

PRAXIS3

100 Peachtree St NW
Suite 1450
Atlanta, GA 30303
404-875-4500 tel
www.praxis3.com

STATE OF GEORGIA
STUART M. ROMM
07/02/26
CERTIFICATE NO. 34651
REGISTERED ARCHITECT

Copyright (c) 2026 Praxis3, LLC

All reports, plans, specifications, computer files, field data, notes and other documents and instruments prepared by Praxis3 shall retain all common law, statutory and other reserved rights, including copyright thereto.

This drawing may not be reproduced in whole or in part without written permission of Praxis3. It is to be returned upon request. Scales as stated are valid on the original drawings.

Rev	Date	Comments
	07/02/2026	PERMIT SET

Client:
FIFTH THIRD BANK

Project Number: 26302
Project Name:
WATSON BLVD.

2711 WATSON BOULEVARD
WARNER ROBINS, GA 31093

Key Plan:

Sheet Title:
BUILDING SECTIONS

Sheet Number:
A-300

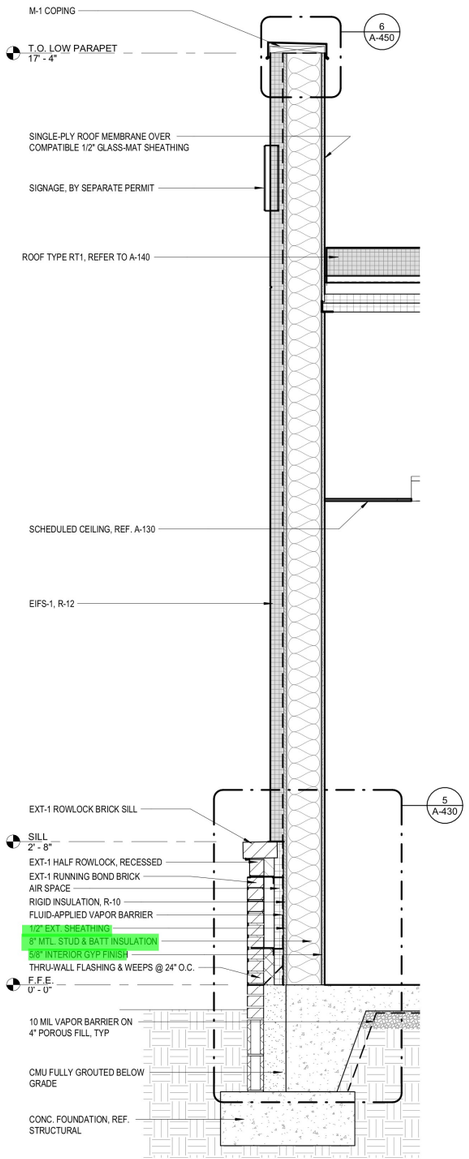

TYPICAL EXTERIOR WALL SECTION | 3/4" = 1'-0" | 3

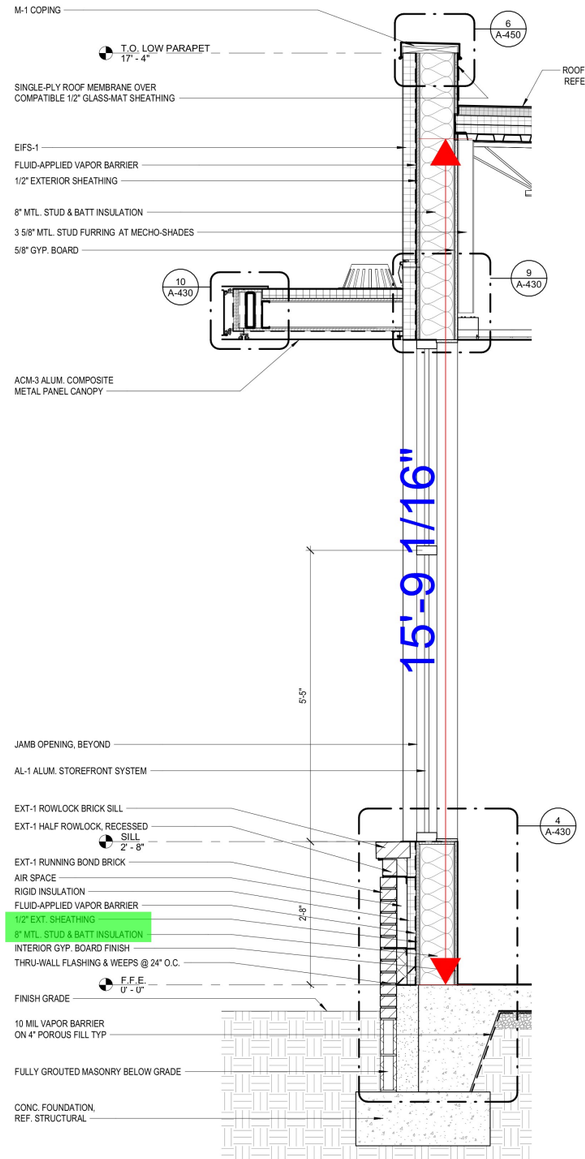

WALL SECTION AT HIGH CANOPY | 3/4" = 1'-0" | 2

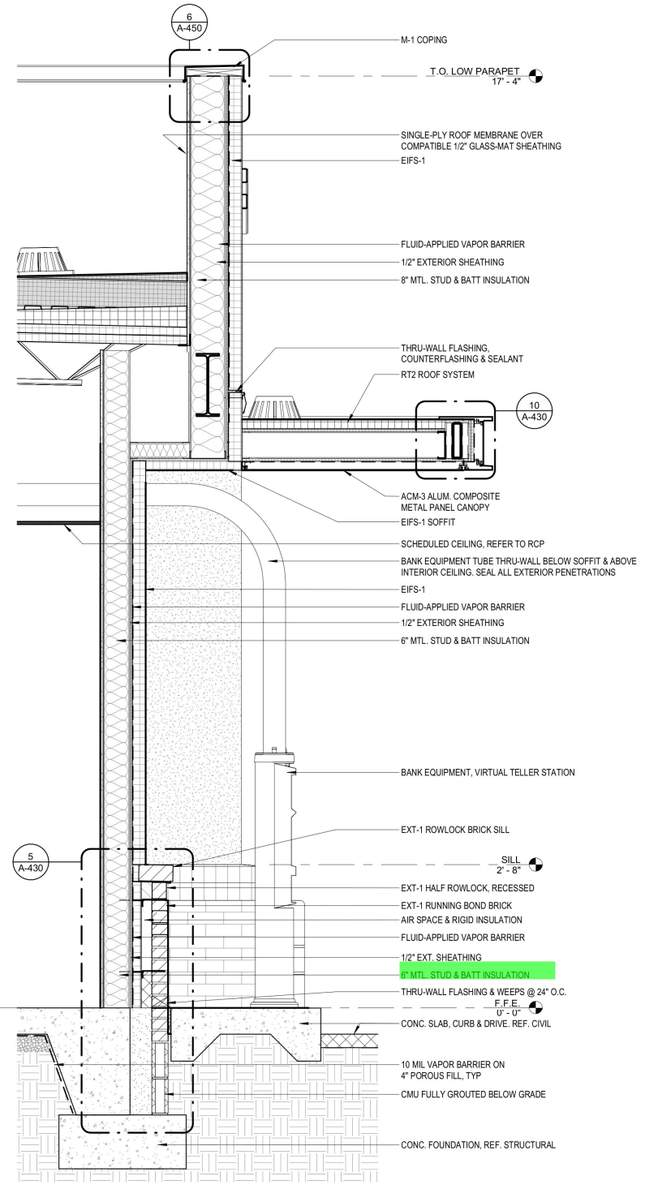

WALL SECTION @ VAT | 3/4" = 1'-0" | 1

7/8/2026 2:38:29 PM

PRAXIS3

100 Peachtree St NW
Suite 1450
Atlanta, GA 30303

404-875-4500 tel
www.praxis3.com

STATE OF GEORGIA
STUART M. ROMM
07/02/26
CERTIFICATE NO. 34651
REGISTERED ARCHITECT

Copyright (c) 2026 Praxis3, LLC

All reports, plans, specifications, computer files, field data, notes and other documents and instruments prepared by Praxis3 shall retain all common law, statutory and other reserved rights, including copyright thereto.

This drawing may not be reproduced in whole or in part without written permission of Praxis3. It is to be returned upon request. Scales as stated are valid on the original drawings.

Rev	Date	Comments
	07/02/2026	PERMIT SET

Client:
FIFTH THIRD BANK

Project Number: 26302
Project Name:
WATSON BLVD.

2711 WATSON BOULEVARD
WARNER ROBINS, GA 31093

Key Plan:

Sheet Title:
EXTERIOR WALL SECTIONS

Sheet Number:
A-310

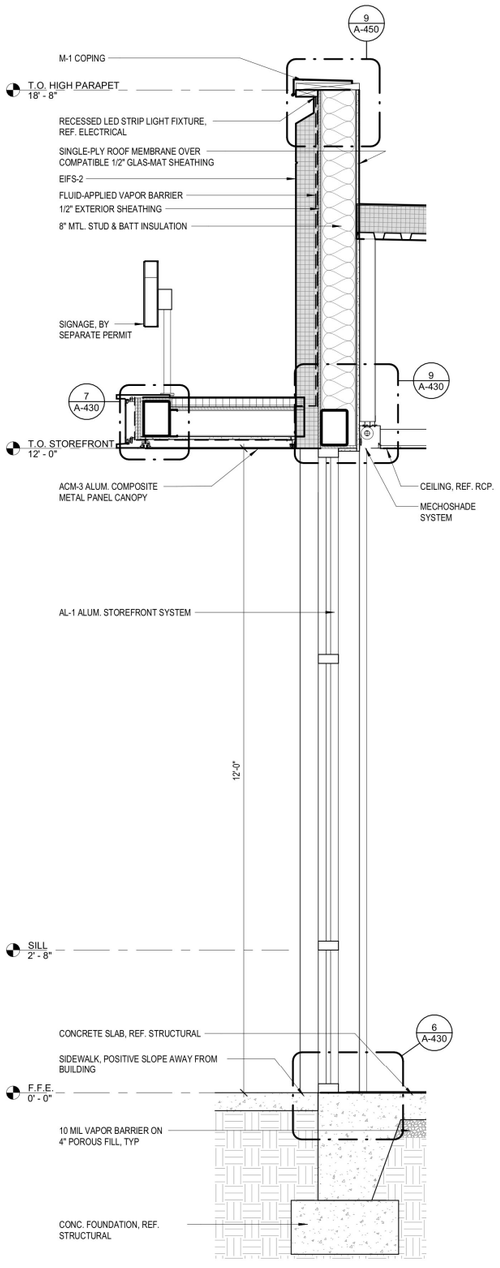

WALL SECTION AT ENTRY VESTIBULE | 3/4" = 1'-0" | 3

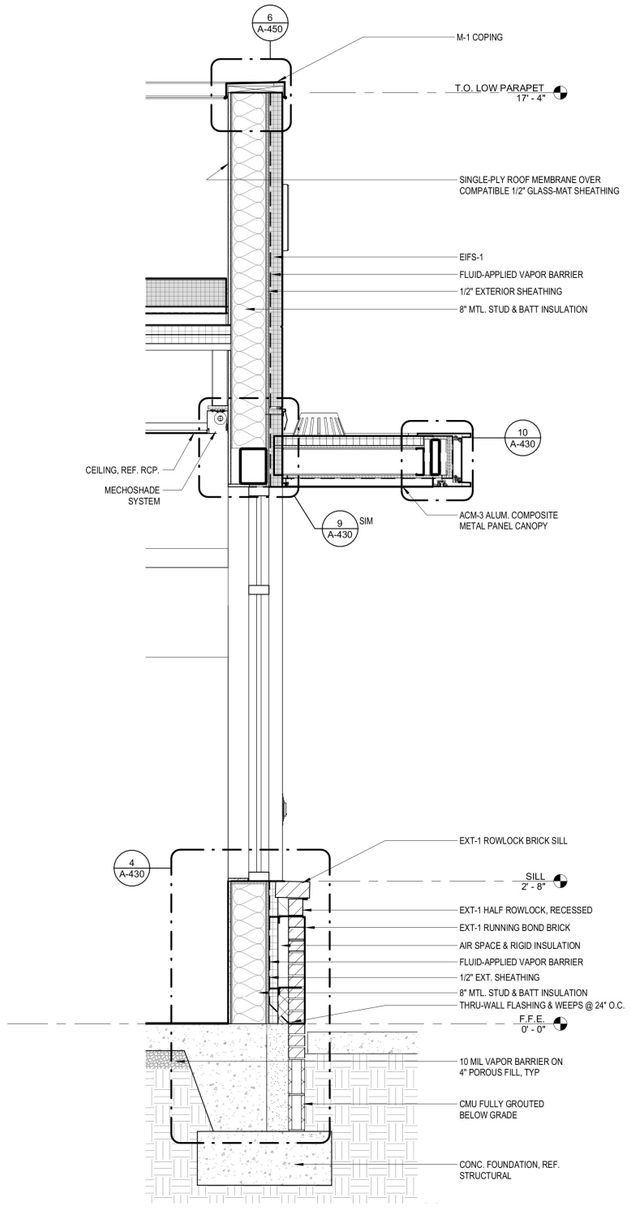

WALL SECTION AT LOW CANOPY | 3/4" = 1'-0" | 2

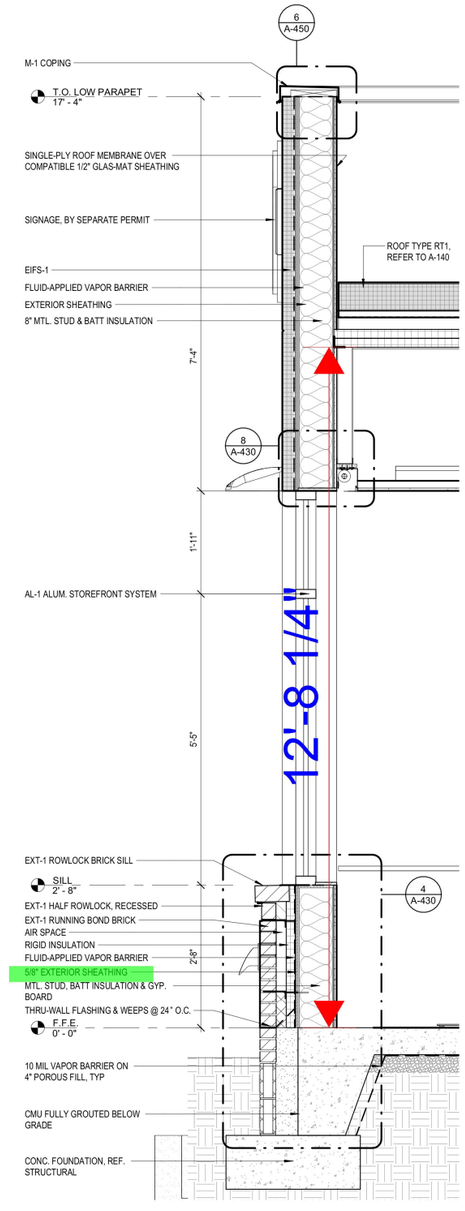

WALL SECTION AT STOREFRONT | 3/4" = 1'-0" | 1

7/8/2026 2:38:31 PM

PRAXIS3

100 Peachtree St NW
Suite 1450
Atlanta, GA 30303

404-875-4500 tel
www.praxis3.com

STATE OF GEORGIA
STUART M. ROMM
07/02/26
CERTIFICATE NO. 34651
REGISTERED ARCHITECT

Copyright (c) 2026 Praxis3, LLC

All reports, plans, specifications, computer files, field data, notes and other documents and instruments prepared by Praxis3 shall retain all common law, statutory and other reserved rights, including copyright thereto.

This drawing may not be reproduced in whole or in part without written permission of Praxis3. It is to be returned upon request. Scales as stated are valid on the original drawings.

Rev	Date	Comments
	07/02/2026	PERMIT SET

Client:
FIFTH THIRD BANK

Project Number: 26302
Project Name:
WATSON BLVD.

2711 WATSON BOULEVARD
WARNER ROBINS, GA 31093

Key Plan:

Sheet Title:
EXTERIOR WALL SECTIONS

Sheet Number:
A-311

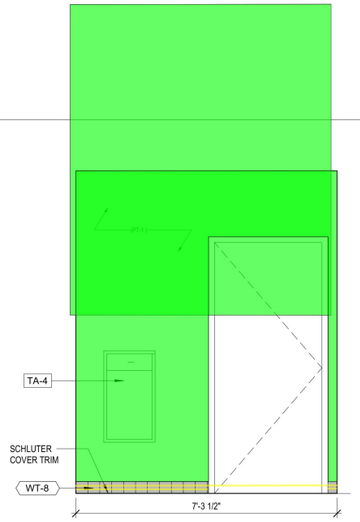

RESTROOM ELEVATION - A | 1/2" = 1'-0" | 10

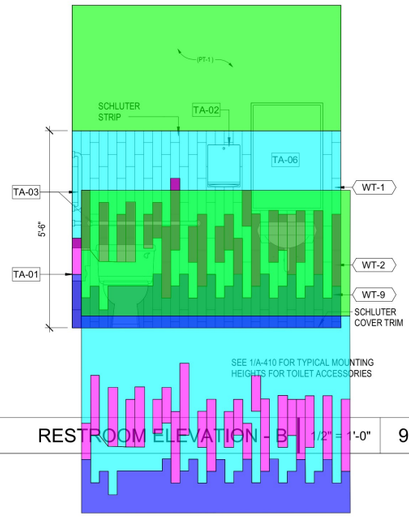

RESTROOM ELEVATION - B | 1/2" = 1'-0" | 9

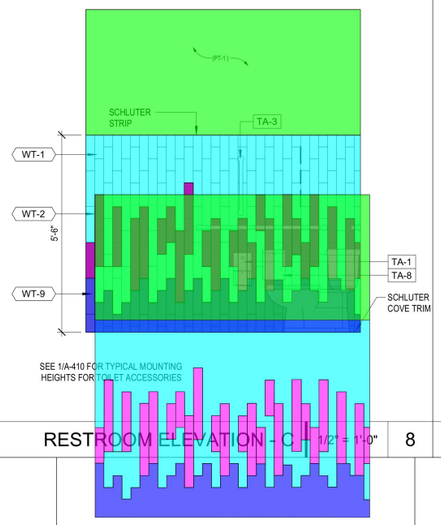

RESTROOM ELEVATION - C | 1/2" = 1'-0" | 8

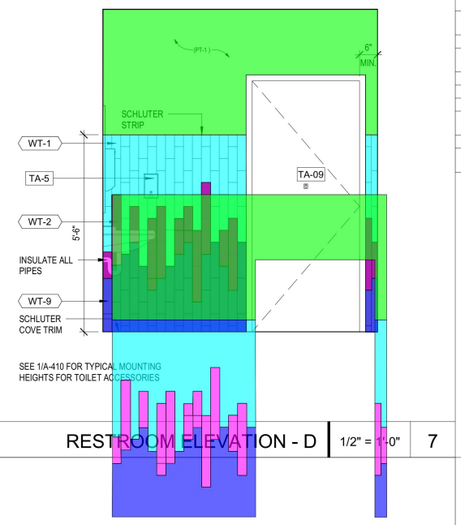

RESTROOM ELEVATION - D | 1/2" = 1'-0" | 7

TOILET ACCESSORY SCHEDULE

ITEM NO	DESCRIPTION	MODEL
TA-01	TOILET TISSUE DISPENSER	OWNER VENDOR PROVIDED, GC TO INSTALL, GC TO ORDER
TA-02	PAPER TOWEL DISPENSER	OWNER VENDOR PROVIDED, GC TO INSTALL, GC TO ORDER
TA-03	GRAB BARS	BRADLEY 1-1/4" STAINLESS STEEL GRAB BAR W/ CONCEALED MOUNTING
TA-04	WASTE RECEPTACLE	BOBRICK B-3644 RECESSED WASTE RECEPTACLE (FOR 4" WALLS)
TA-05	SOAP DISPENSER	OWNER VENDOR PROVIDED, GC TO INSTALL, GC TO ORDER
TA-06	MIRROR	BOBRICK B-290 GLASS MIRROR WITH STAINLESS STEEL ANGLE FRAME
TA-08	SANITARY NAPKIN DISPOSAL	BOBRICK B-270 SURFACE MOUNTED SANITARY NAPKIN DISPOSAL
TA-09	COAT HOOK	REFERENCE DOOR HW SCHEDULE
TA-10	SURFACE MOUNTED MOP HOLDER	BOBRICK B-223 x 24, SATIN FINISH

GC: SCAN QR CODE FOR LINK TO ORDER TOILET ACCESSORIES
"BY OWNER VENDOR, GC INSTALL"
https://app.smartsheet.com/b/form/d7330a3854794f519c389721265979be

NOTE:
MENS INTERIOR ELEVATIONS ARE SIMILAR TO WOMENS INTERIOR ELEVATIONS

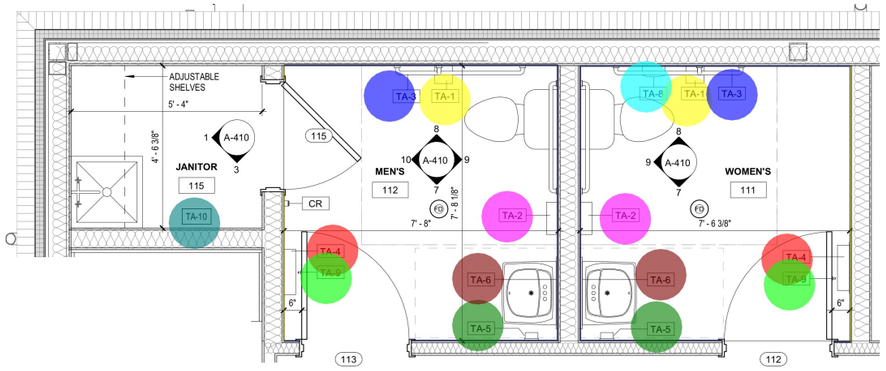

ENLARGED RESTROOM PLAN | 1/2" = 1'-0" | 6

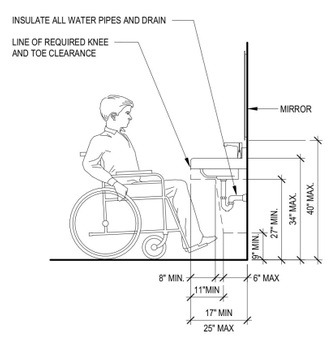

ACCESSIBLE - LAV | 1/2" = 1'-0" | 5

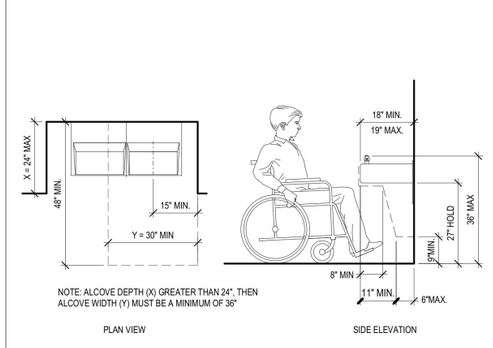

ACCESSIBLE - DRINKING FOUNTAINS | 1/2" = 1'-0" | 4

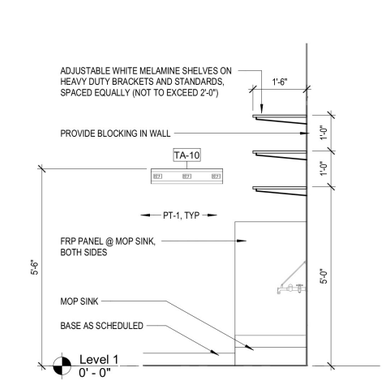

JANITOR CLOSET ELEVATION | 1/2" = 1'-0" | 3

PT1 WALL PAINT	252.6 SQ FT
WT-8 BASE	11.3 FT
WT9 WALL TILE	50.6 SQ FT
WT2 WALL TILE	43.8 SQ FT
WT1 WALL TILE	120.7 SQ FT
TA10	1.0 EA
TA4	2.0 EA
TA9	2.0 EA
TA1	2.0 EA
TA3	2.0 EA
TA2	2.0 EA
TA8	1.0 EA
TA6	2.0 EA
TA5	2.0 EA
SCHLUTER COVE TRIM	51.9 FT
SCHLUTER TRIM	39.6 FT
1'6"D ADJUSTABLE WHITE MELAMINE SHELVES ON HEAVY DUTY BRACKET	12.7 FT

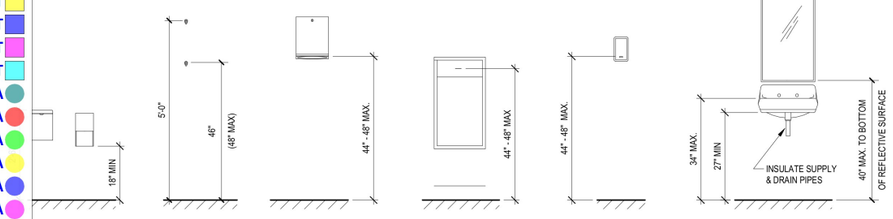

TYPICAL ACCESSIBLE ACCESSORY HEIGHTS | 1/2" = 1'-0" | 2

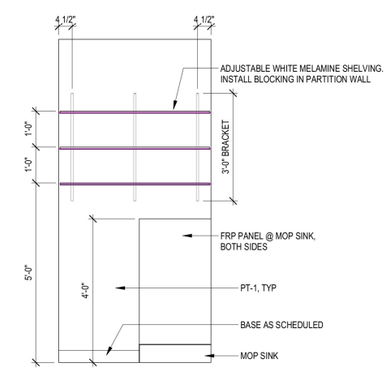

JANITOR CLOSET ELEVATION | 1/2" = 1'-0" | 1

PRAXIS3
100 Peachtree St NW
Suite 1450
Atlanta, GA 30303
404-875-4500 tel
www.praxis3.com

STATE OF GEORGIA
STUART M. ROMM
07/02/26
CERTIFICATE NO. 34652
REGISTERED ARCHITECT

Copyright (c) 2026 Praxis3, LLC

All reports, plans, specifications, computer files, field data, notes and other documents and instruments prepared by Praxis3 shall retain all common law, statutory and other reserved rights, including copyright thereto.

This drawing may not be reproduced in whole or in part without written permission of Praxis3. It is to be returned upon request. Scales as stated are valid on the original drawings.

Rev	Date	Comments
	07/02/2026	PERMIT SET

Client:
FIFTH THIRD BANK

Project Number: 26302
Project Name:
WATSON BLVD.

2711 WATSON BOULEVARD
WARNER ROBINS, GA 31093

Key Plan:

Sheet Title:
ENLARGED RESTROOM PLANS & ELEVATIONS

Sheet Number:
A-410

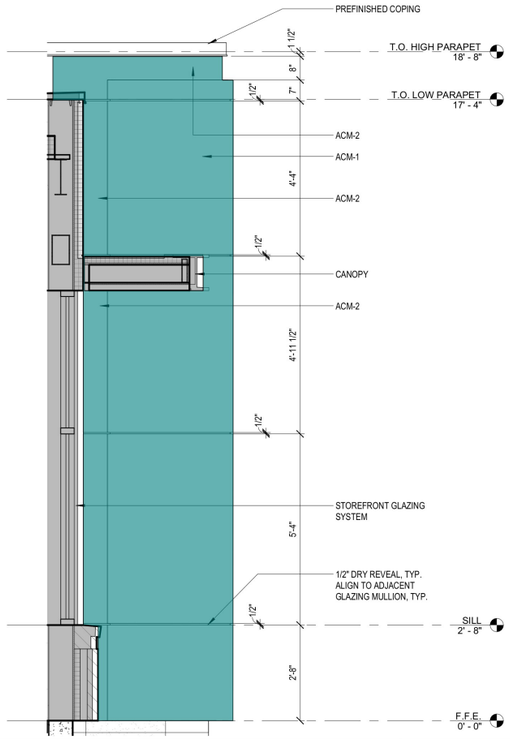

WING WALL ELEVATION | 1/2" = 1'-0" | 6

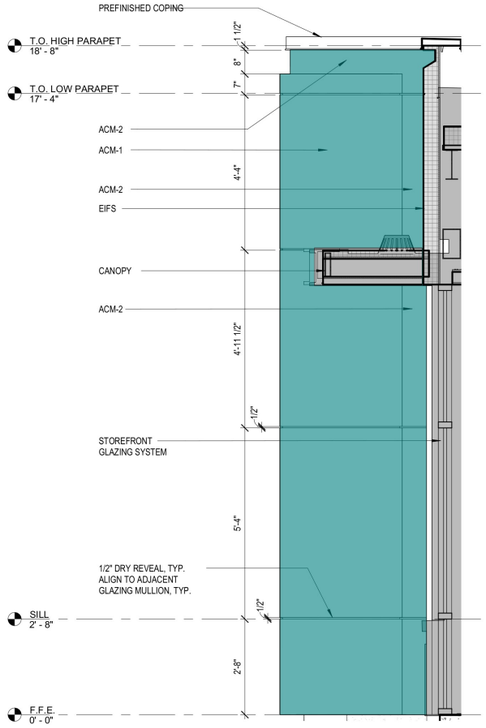

WING WALL ELEVATION | 1/2" = 1'-0" | 5

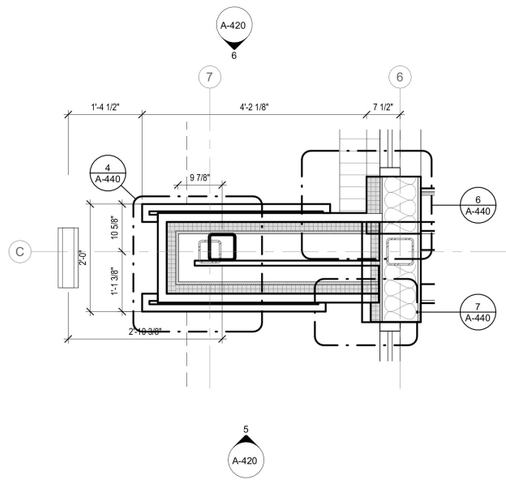

WING WALL ENLARGED PLAN | 3/4" = 1'-0" | 2

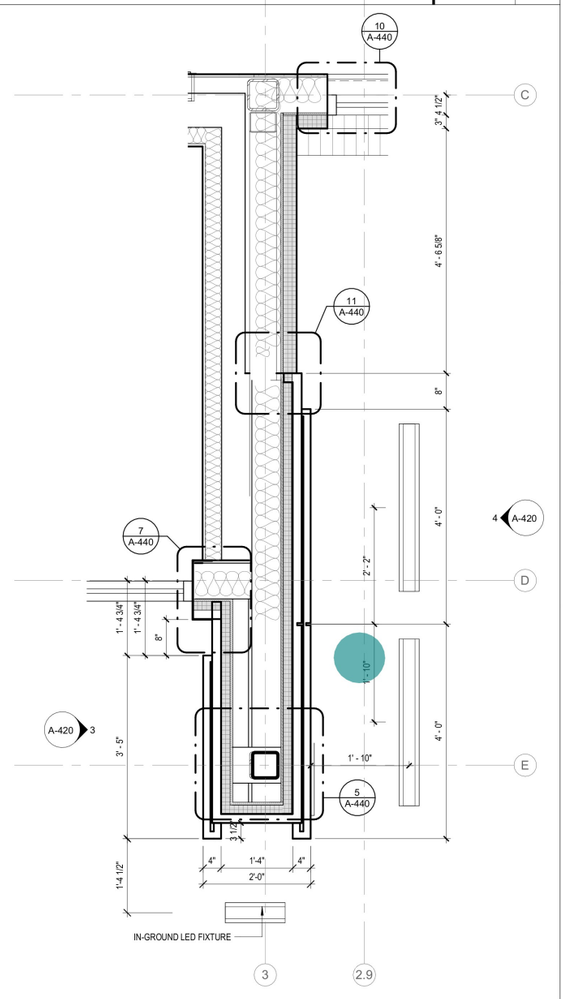

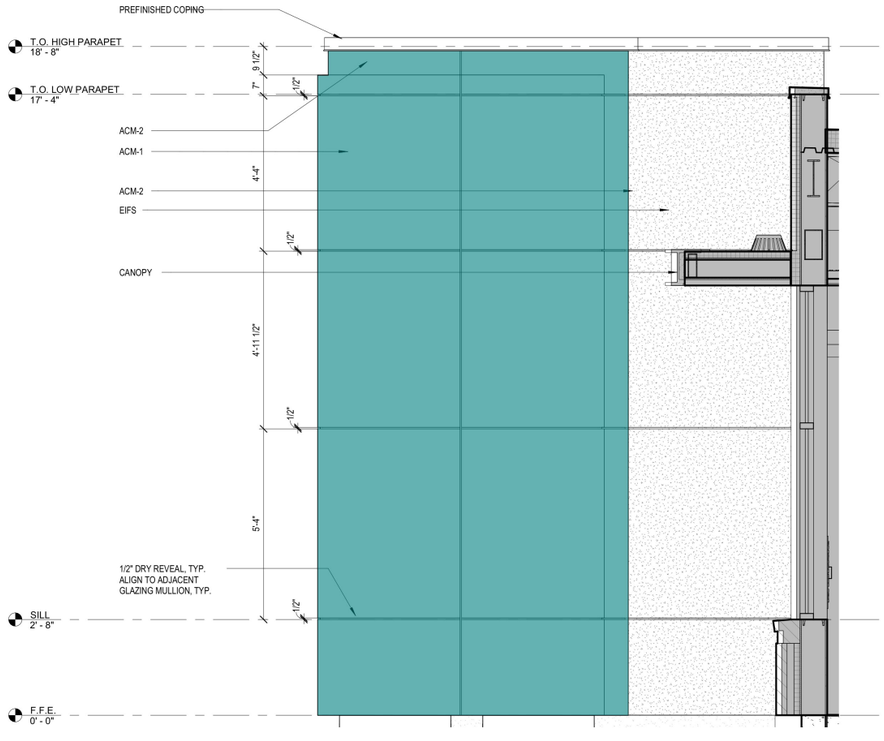

WING WALL ELEVATION | 1/2" = 1'-0" | 4

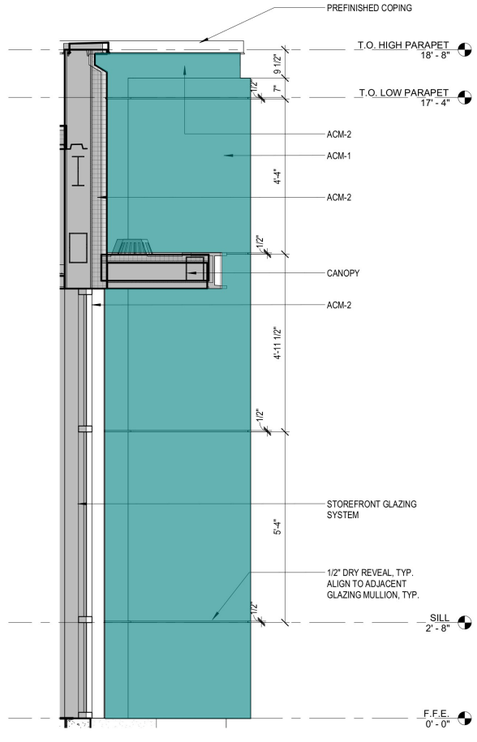

WING WALL ELEVATION | 1/2" = 1'-0" | 3

ACM1, ACM2 FINISH - 1/A440
CONFIRM DETAIL AFTER WALL EXCEL

379.6 SQ FT
1.0 EA

38:39 PM

PRAXIS3

100 Peachtree St NW
Suite 1450
Atlanta, GA 30303
404-875-4500 tel
www.praxis3.com

STATE OF GEORGIA
STUART M. ROMM
07/02/26
CERTIFICATE NO. 34651
REGISTERED ARCHITECT

Copyright (c) 2026 Praxis3, LLC

All reports, plans, specifications, computer files, field data, notes and other documents and instruments prepared by Praxis3 shall retain all common law, statutory and other reserved rights, including copyright thereto.

This drawing may not be reproduced in whole or in part without written permission of Praxis3. It is to be returned upon request. Scales as stated are valid on the original drawings.

Rev	Date	Comments
	07/02/2026	PERMIT SET

Client:
FIFTH THIRD BANK

Project Number: 26302
Project Name:
WATSON BLVD.

2711 WATSON BOULEVARD
WARNER ROBINS, GA 31093

Key Plan:

Sheet Title:
ENLARGED WING WALL PLANS & ELEVATIONS

Sheet Number:
A-420

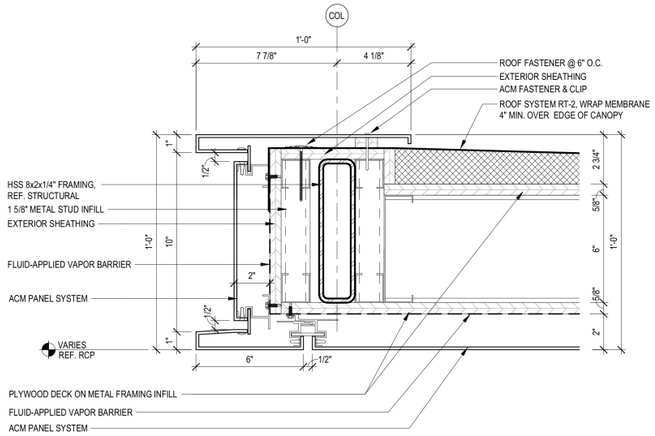

CANOPY EDGE DETAIL | 3" = 1'-0" | 10

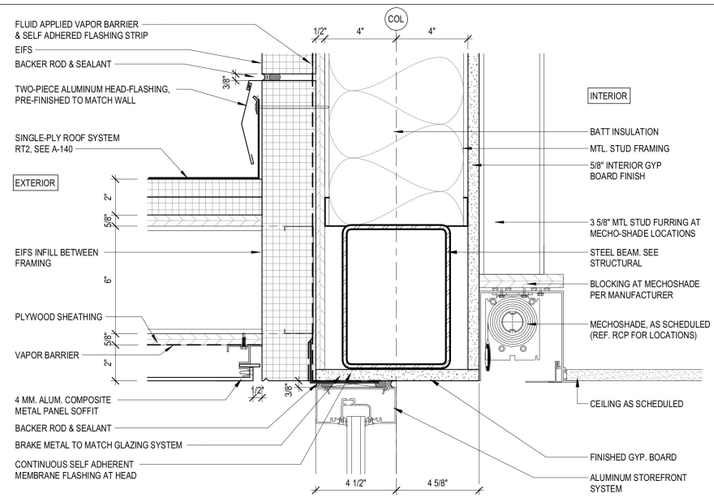

STOREFRONT HEAD @ CANOPY | 3" = 1'-0" | 9

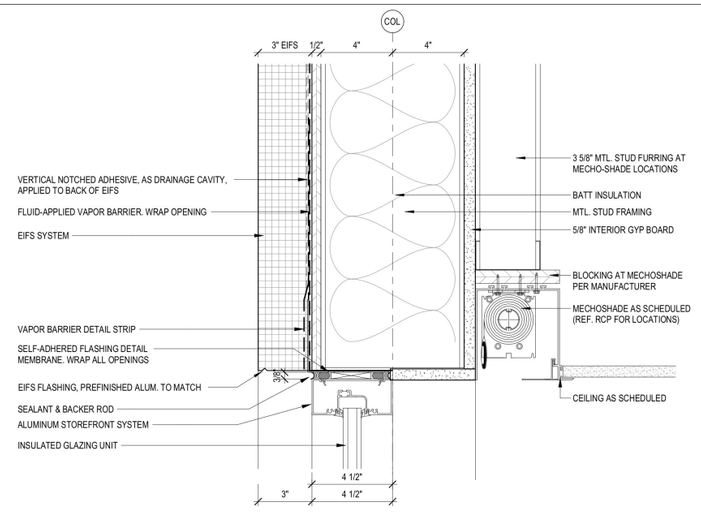

STOREFRONT HEAD @ TYP. EIFS | 3" = 1'-0" | 8

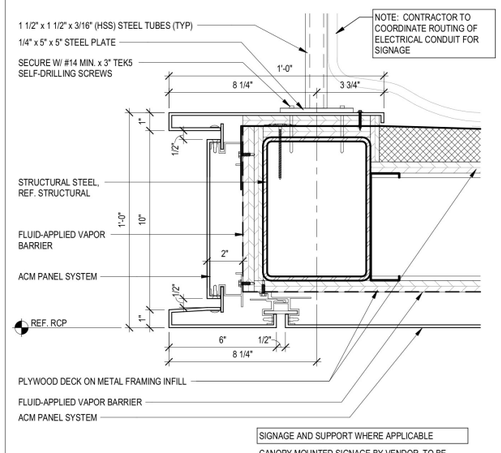

CANOPY EDGE DETAIL AT SIGNAGE | 3" = 1'-0" | 7

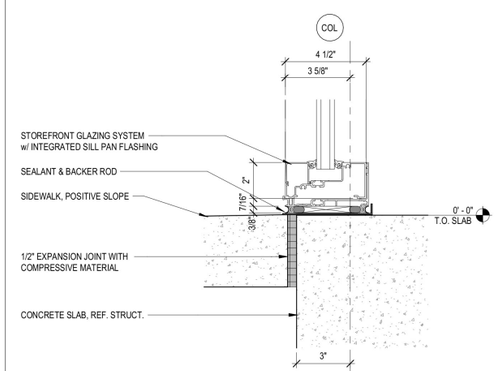

STOREFRONT SILL @ SLAB EDGE | 3" = 1'-0" | 6

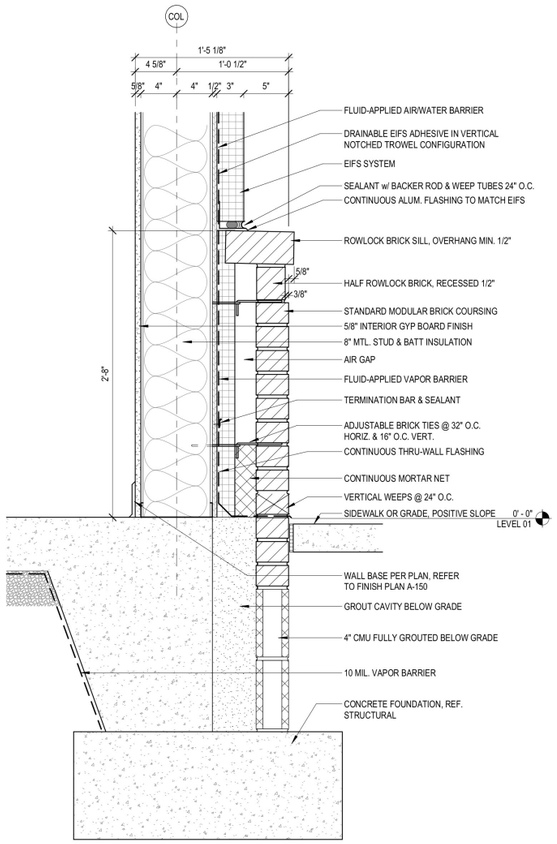

MASONRY SILL TO EIFS | 1 1/2" = 1'-0" | 5

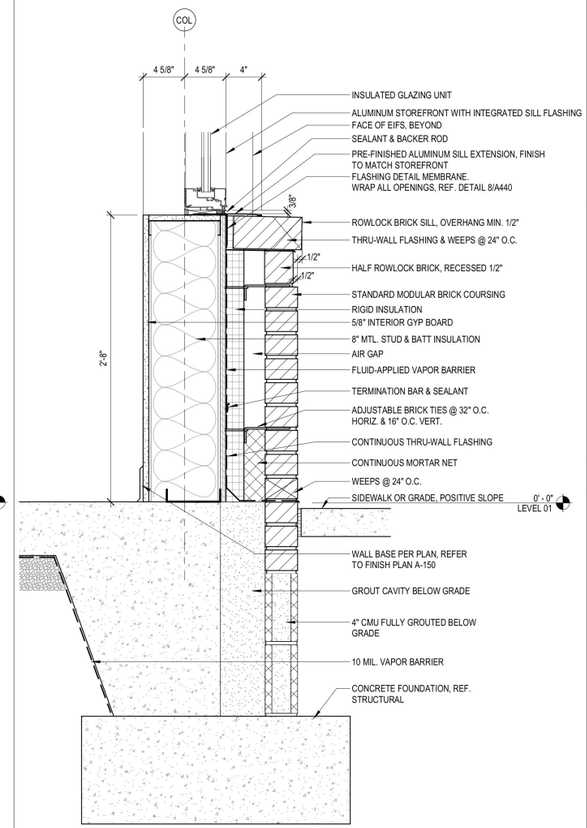

SECTION DETAIL @ MASONRY BASE | 1 1/2" = 1'-0" | 4

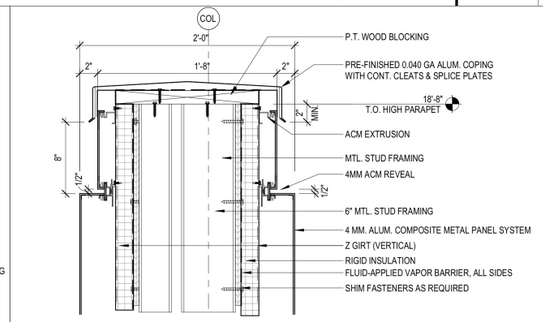

COPING DETAIL @ WING WALL | 1 1/2" = 1'-0" | 3

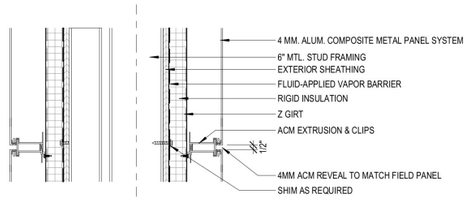

SECTION DETAIL @ ACM HORIZONTAL JOINT | 1 1/2" = 1'-0" | 2

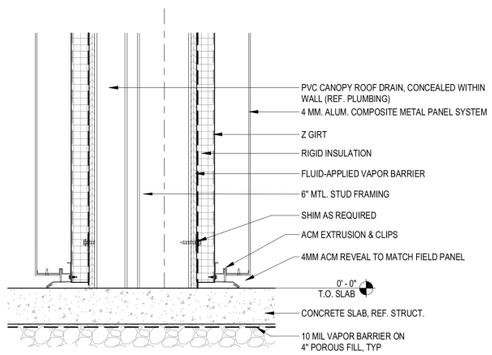

SECTION DETAIL @ ACM WALL | 1 1/2" = 1'-0" | 1

PRAXIS3
100 Peachtree St NW
Suite 1450
Atlanta, GA 30303
404-875-4500 tel
www.praxis3.com

STATE OF GEORGIA
STUART M. ROMM
07/02/26
CERTIFICATE NO. 34625
REGISTERED ARCHITECT

Copyright (c) 2026 Praxis3, LLC

All reports, plans, specifications, computer files, field data, notes and other documents and instruments prepared by Praxis3 shall retain all common law, statutory and other reserved rights, including copyright thereto.

This drawing may not be reproduced in whole or in part without written permission of Praxis3. It is to be returned upon request. Scales as stated are valid on the original drawings.

Rev	Date	Comments
	07/02/2026	PERMIT SET

Client:
FIFTH THIRD BANK

Project Number: 26302
Project Name:
WATSON BLVD.

2711 WATSON BOULEVARD
WARNER ROBINS, GA 31093

Key Plan:

Sheet Title:
SECTION DETAILS

Sheet Number:
A-430

7/8/2026 2:38:41 PM

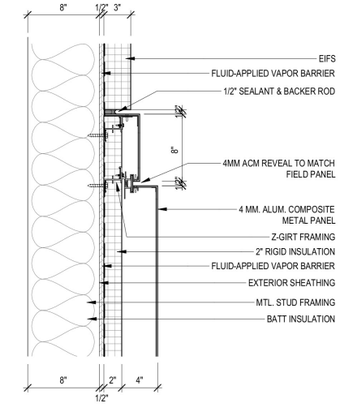

WING WALL JOINT @ EIFS | 1 1/2" = 1'-0" | 11

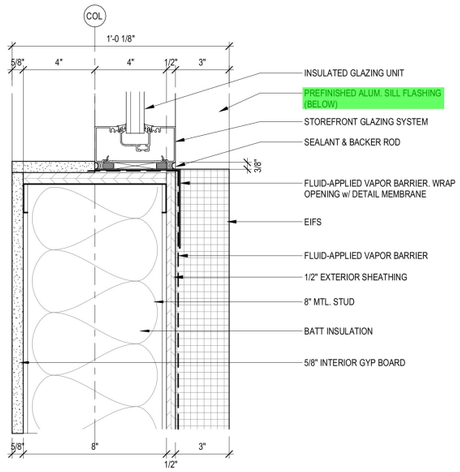

STOREFRONT JAMB @ TYP. EIFS | 3" = 1'-0" | 10

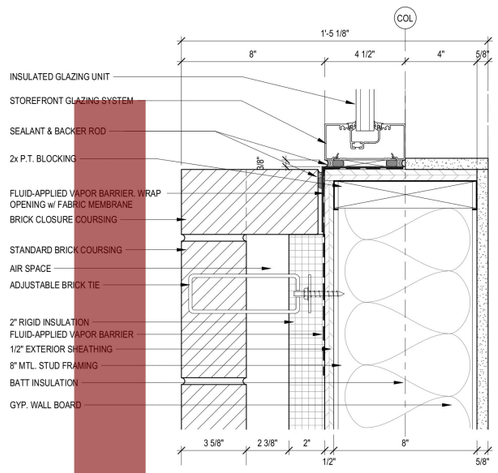

STOREFRONT JAMB @ TYP. BRICK | 3" = 1'-0" | 9

VAPOR BARRIER FLASHING SEQUENCE:
1. INSTALL FLUID-APPLIED AIR BARRIER TO ENTIRE FACADE AND TAKE MATERIAL TO EDGE OF ALL OPENINGS
2. INSTALL FLASHING TAPE AT SILL
3. INSTALL CORNER FLASHING OVER TAPE
4. INSTALL SELF-ADHERING METAL CLAD FLASHING TO SILL
5. INSTALL FLASHING TAPE AT JAMBS
6. INSTALL FLASHING TAPE AT HEAD
7. INSTALL SELF-ADHERING METAL CLAD FLASHING AT HEAD
8. INSTALL TERMINATION BAR AND SEALANT AT TOP OF HEAD FLASHING

NOTE:
-NO REVERSE LAPS
-INTERIOR AND EXTERIOR LAPS TO BE 4" MIN.

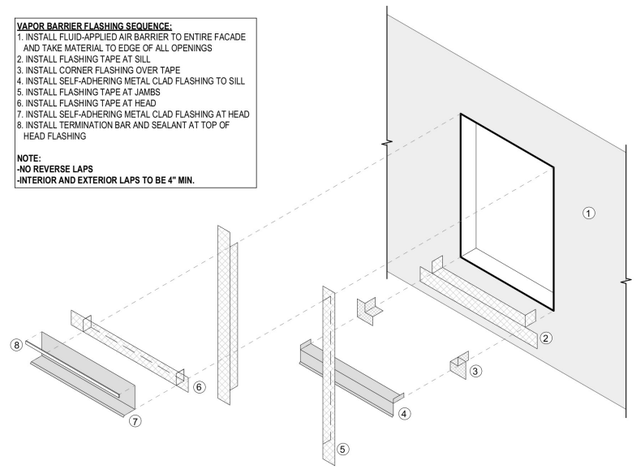

VAPOR BARRIER FLASHING SEQUENCE | 1/2" = 1'-0" | 8

STOREFRONT JAMB @ WING WALL | 1 1/2" = 1'-0" | 7

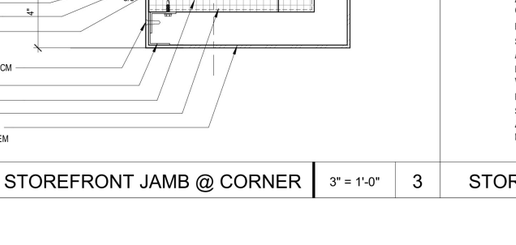

STOREFRONT JAMB @ WING WALL | 1 1/2" = 1'-0" | 6

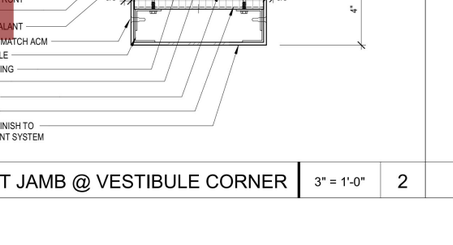

WING WALL (LONG) PLAN DETAIL | 1 1/2" = 1'-0" | 5

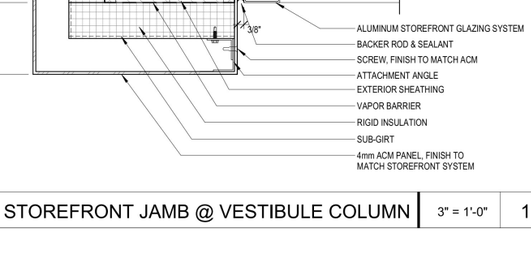

WING WALL (SHORT) PLAN DETAIL | 1 1/2" = 1'-0" | 4

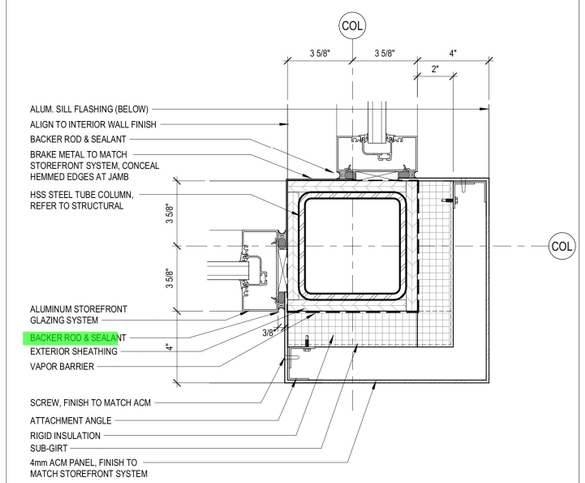

STOREFRONT JAMB @ CORNER | 3" = 1'-0" | 3

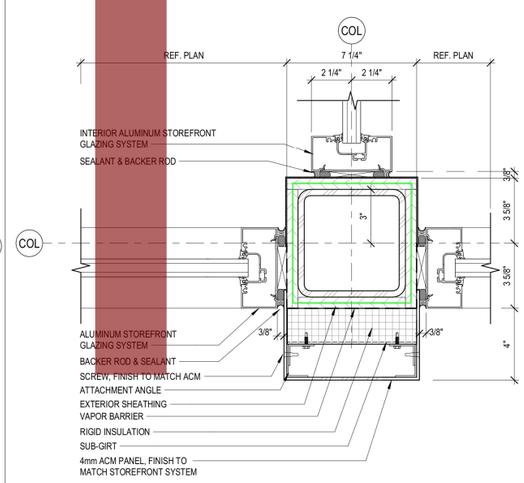

STOREFRONT JAMB @ VESTIBULE CORNER | 3" = 1'-0" | 2

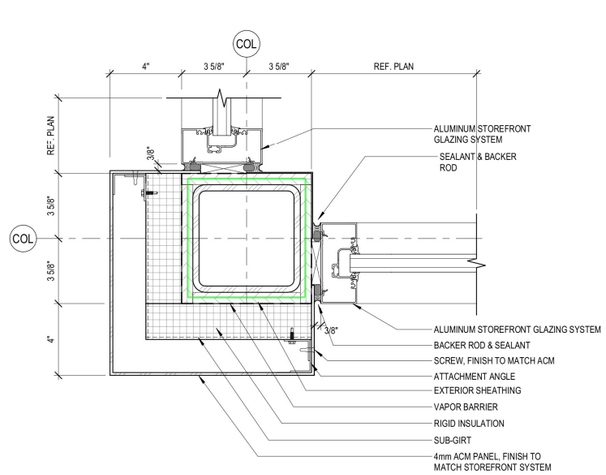

STOREFRONT JAMB @ VESTIBULE COLUMN | 3" = 1'-0" | 1

PRAXIS3

100 Peachtree St NW
Suite 1450
Atlanta, GA 30303
404-875-4500 tel
www.praxis3.com

STATE OF GEORGIA
STUART M. ROMM
07/02/26
CERTIFICATE NO. 34651
REGISTERED ARCHITECT

Copyright (c) 2026 Praxis3, LLC

All reports, plans, specifications, computer files, field data, notes and other documents and instruments prepared by Praxis3 shall retain all common law, statutory and other reserved rights, including copyright thereto.

This drawing may not be reproduced in whole or in part without written permission of Praxis3. It is to be returned upon request. Scales as stated are valid on the original drawings.

Rev	Date	Comments
	07/02/2026	PERMIT SET

Client:
FIFTH THIRD BANK

Project Number: 26302
Project Name:
WATSON BLVD.

2711 WATSON BOULEVARD
WARNER ROBINS, GA 31093

Key Plan:

Sheet Title:
PLAN DETAILS

Sheet Number:
A-440

7/8/2026 2:38:42 PM

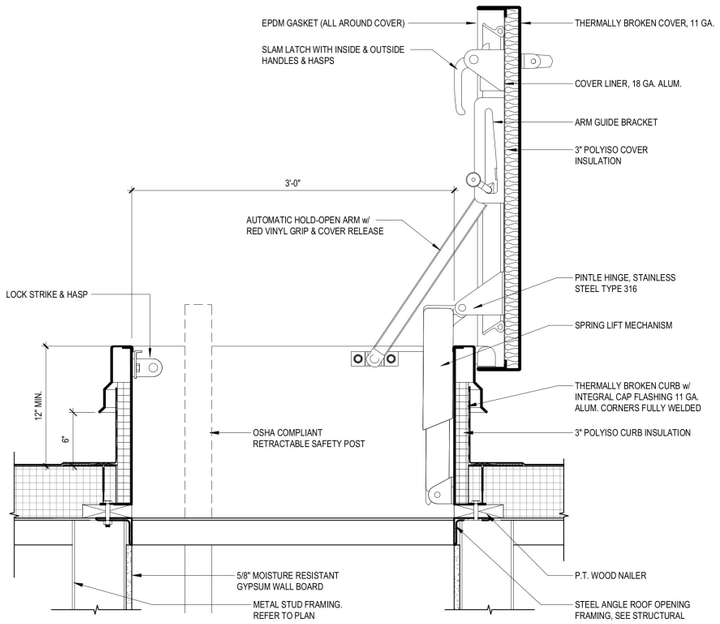

ENLARGED ROOF HATCH DETAIL | 1 1/2" = 1'-0" | 11

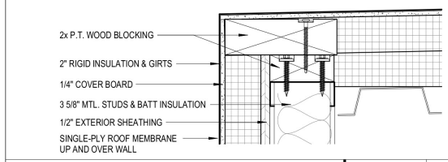

ROOF TRANSITION DETAIL | 3" = 1'-0" | 10

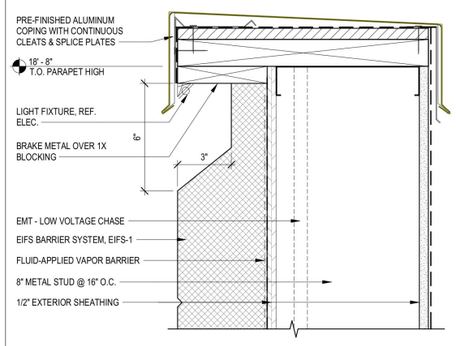

COPING DETAIL | 3" = 1'-0" | 9

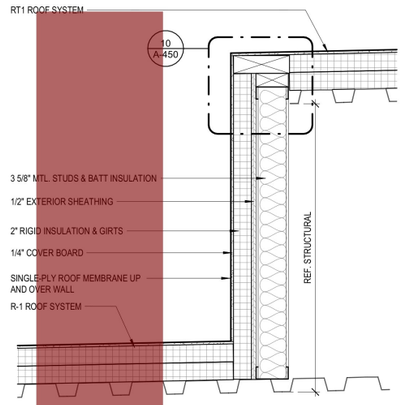

HIGH-LOW ROOF DETAIL | 1 1/2" = 1'-0" | 8

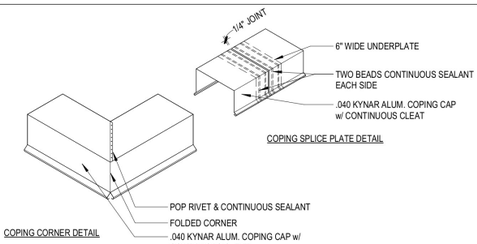

ROOF COPING SPLICE DETAIL | 1 1/2" = 1'-0" | 7

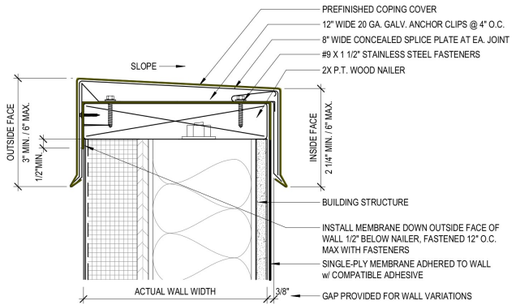

ROOF COPING DETAIL | 3" = 1'-0" | 6

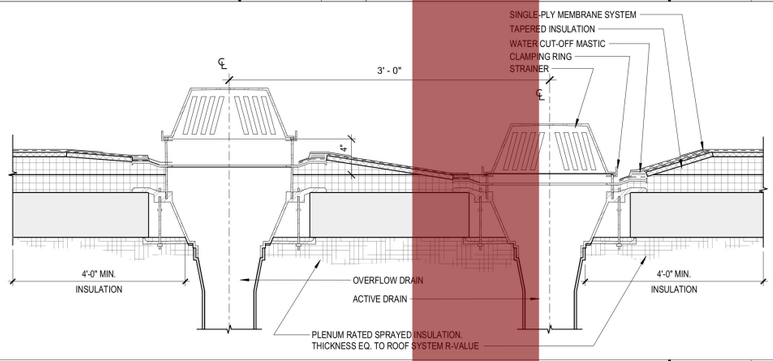

PRIMARY & SECONDARY DRAIN DETAIL | 1 1/2" = 1'-0" | 5

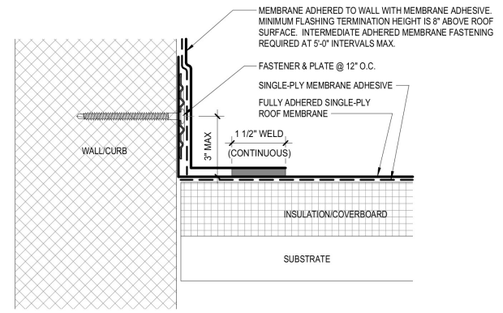

BASE TIE-IN FLASHING DETAIL | 6" = 1'-0" | 4

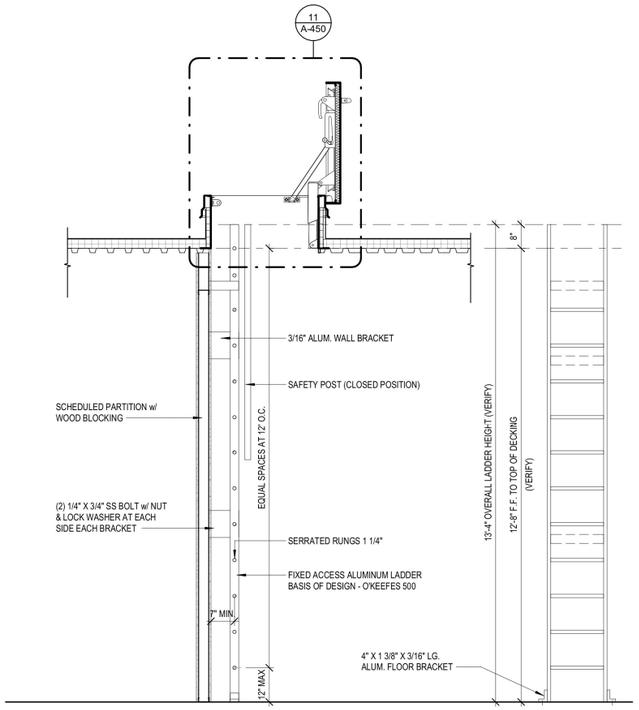

ROOF HATCH & LADDER DETAIL | 1/2" = 1'-0" | 3

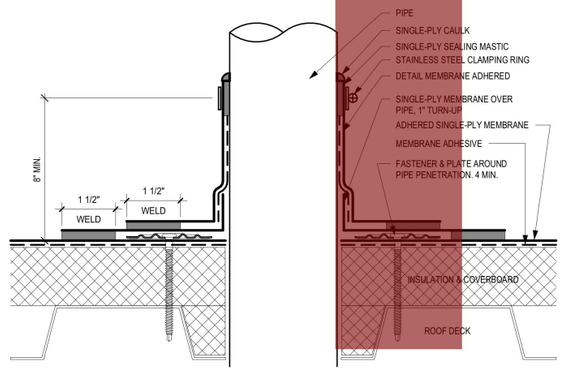

ROOF PIPE PENETRATION DETAIL | 6" = 1'-0" | 2

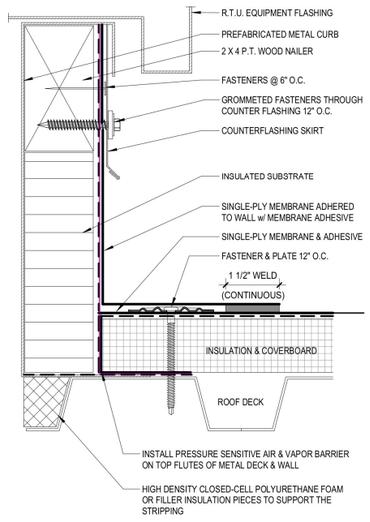

EQUIPMENT CURB DETAIL | 6" = 1'-0" | 1

7/8/2026 2:38:44 PM

PRAXIS3

100 Peachtree St NW
Suite 1450
Atlanta, GA 30303
404-875-4500 tel
www.praxis3.com

STATE OF GEORGIA
STUART M. ROMM
07/02/26
CERTIFICATE NO. 34652
REGISTERED ARCHITECT

Copyright (c) 2026 Praxis3, LLC

All reports, plans, specifications, computer files, field data, notes and other documents and instruments prepared by Praxis3 shall retain all common law, statutory and other reserved rights, including copyright thereto.

This drawing may not be reproduced in whole or in part without written permission of Praxis3. It is to be returned upon request. Scales as stated are valid on the original drawings.

Rev	Date	Comments
	07/02/2026	PERMIT SET

Client:
FIFTH THIRD BANK

Project Number: 26302
Project Name:
WATSON BLVD.

2711 WATSON BOULEVARD
WARNER ROBINS, GA 31093

Key Plan:

Sheet Title:
ROOF DETAILS

Sheet Number:
A-450